

RESOLUTION NO. 214123

R. 76-122
AUG 28 1975

VACATION OF COLIMA STREET BETWEEN CHELSEA AVENUE AND SEA ROSE PLACE; AN UNNAMED ALLEY SOUTH OF BLOCK 36, BETWEEN CALUMET AVENUE AND SEA ROSE PLACE, BIRD ROCK ADDITION, MAP NO. 1083.

WHEREAS, it is proposed that COLIMA STREET between Chelsea Avenue and Sea Rose Place; an unnamed ALLEY south of Block 36, between Calumet Avenue and Sea Rose Place, Bird Rock Addition, Map No. 1083 be vacated; and

WHEREAS, there is no present or prospective use for the street, either for the public street system for which the right-of-way was originally acquired or for any other public use of a like nature that can be anticipated; and

WHEREAS, the public will benefit from the vacation through improved utilization of land; and

WHEREAS, the vacation or abandonment is not inconsistent with the General Plan or an approved Community Plan; and

WHEREAS, the public street system for which the right-of-way was originally acquired will not be detrimentally affected by this vacation; NOW, THEREFORE,

BE IT RESOLVED, by the Council of The City of San Diego, California, that COLIMA STREET between Chelsea Avenue and Sea Rose Place; an unnamed ALLEY south of Block 36, between Calumet Avenue and Sea Rose Place, Bird Rock Addition, Map No. 1083, as more particularly referred to in Resolution of Intention No. 213899 is unnecessary for present or prospective public street purposes.

MICROFILMED


MAY 18 1978

01322

BE IT FURTHER RESOLVED, that COLIMA STREET between Chelsea Avenue and Sea Rose Place; and unnamed ALLEY south of Block 36, between Calumet Avenue and Sea Rose Place, Bird Rock Addition, Map No. 1083, as more particularly shown on tentative Subdivision Map of Calumet Park, T.M. 73-185, a copy of which is on file in the office of the City Clerk as Document No. 752191, is hereby ordered vacated.

BE IT FURTHER RESOLVED, that the City Clerk shall cause a certified copy of this resolution, attested by him under seal, to be recorded in the office of the County Recorder.

APPROVED: JOHN W. WITT, City Attorney

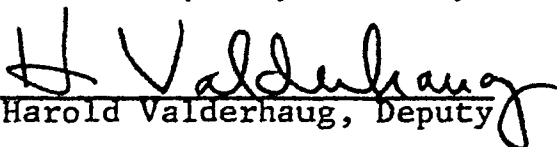By 
Harold Valderhaug, Deputy


HOV:jat
7-18-75

MICROFILMED

MAY 18 1978

01324


DEDICATE & IMPROVE TO PROVIDE
24' OF PAVEMENT, CB. & SIDEW.
ULTIMATE ROADWAY IS 36'/56'

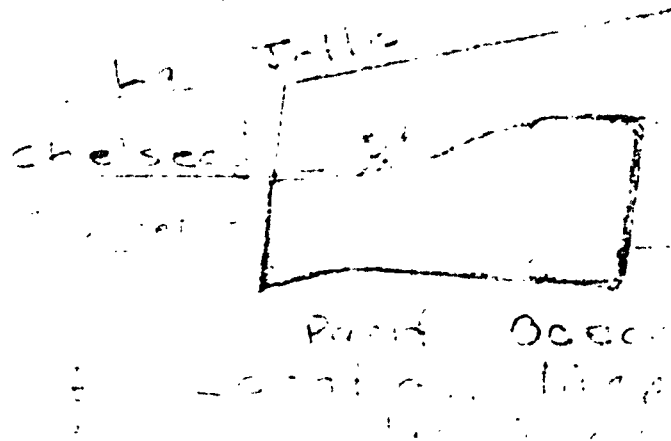

Scale 1" = 40'

Final
grading plan
with
SE/H

* NOTE:
~~LOTS 30 & 31~~
~~AND THREE~~
 DEDICATED TO THE
 CITY SOLELY FOR PARK
 AND RECREATION
 PURPOSES, ~~AND~~
~~FOR~~
~~AND~~
~~AND~~
~~AND~~

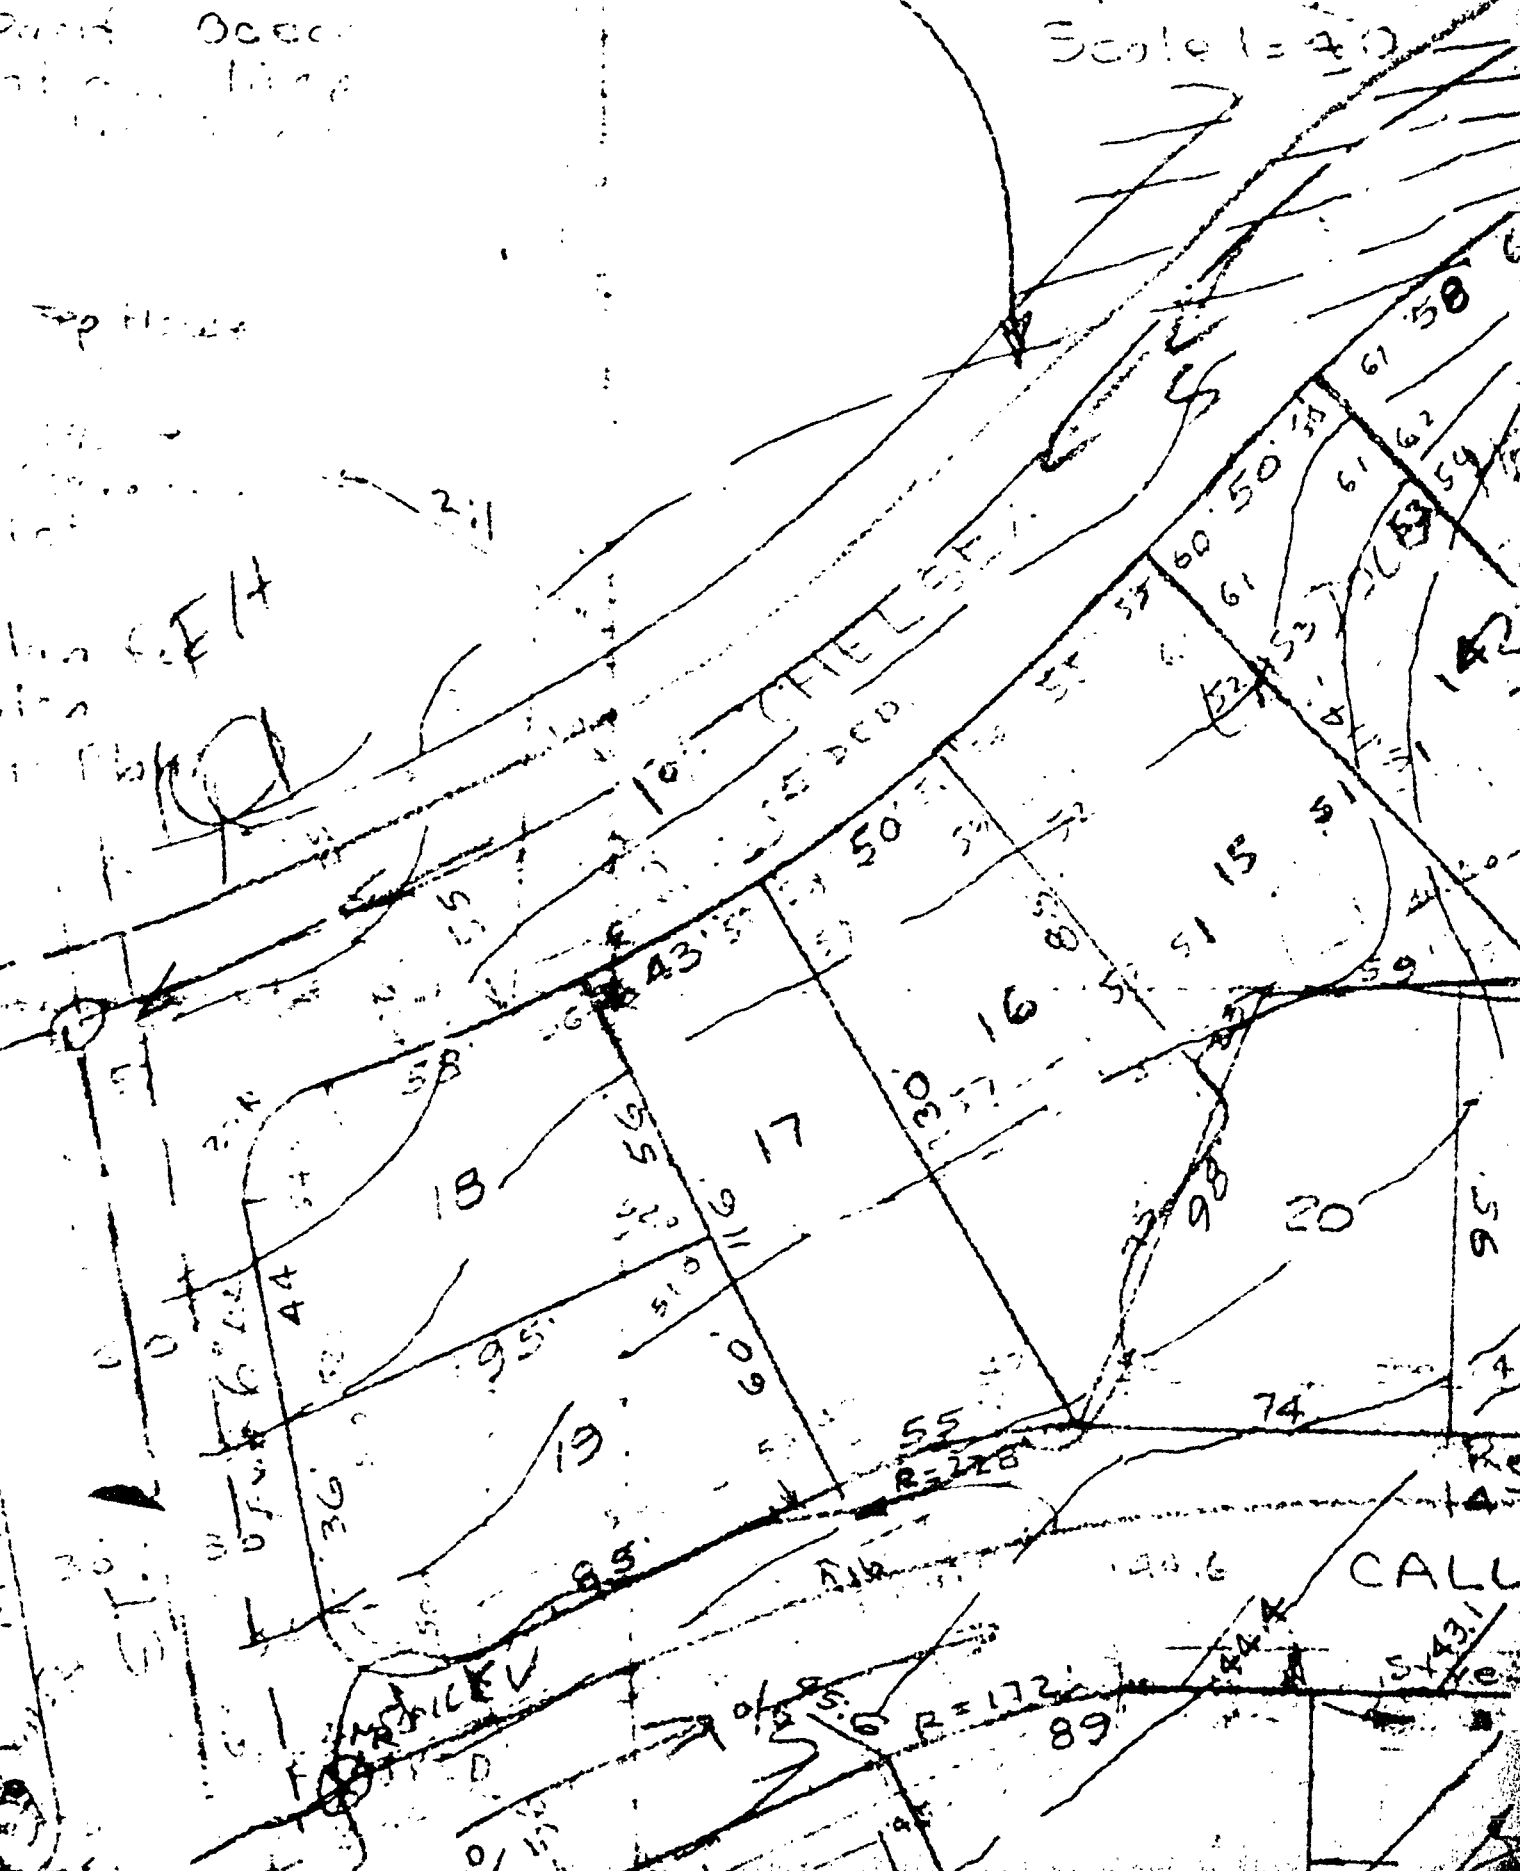


01325

01326

PORTION OF COLIMA ST.
TO BE VACATED

DICATE & IMPROVE TO PROVIDE
OF PAVEMENT, CB. & SIDEWALK.
MINUTE ROADWAY IS 36'/56'

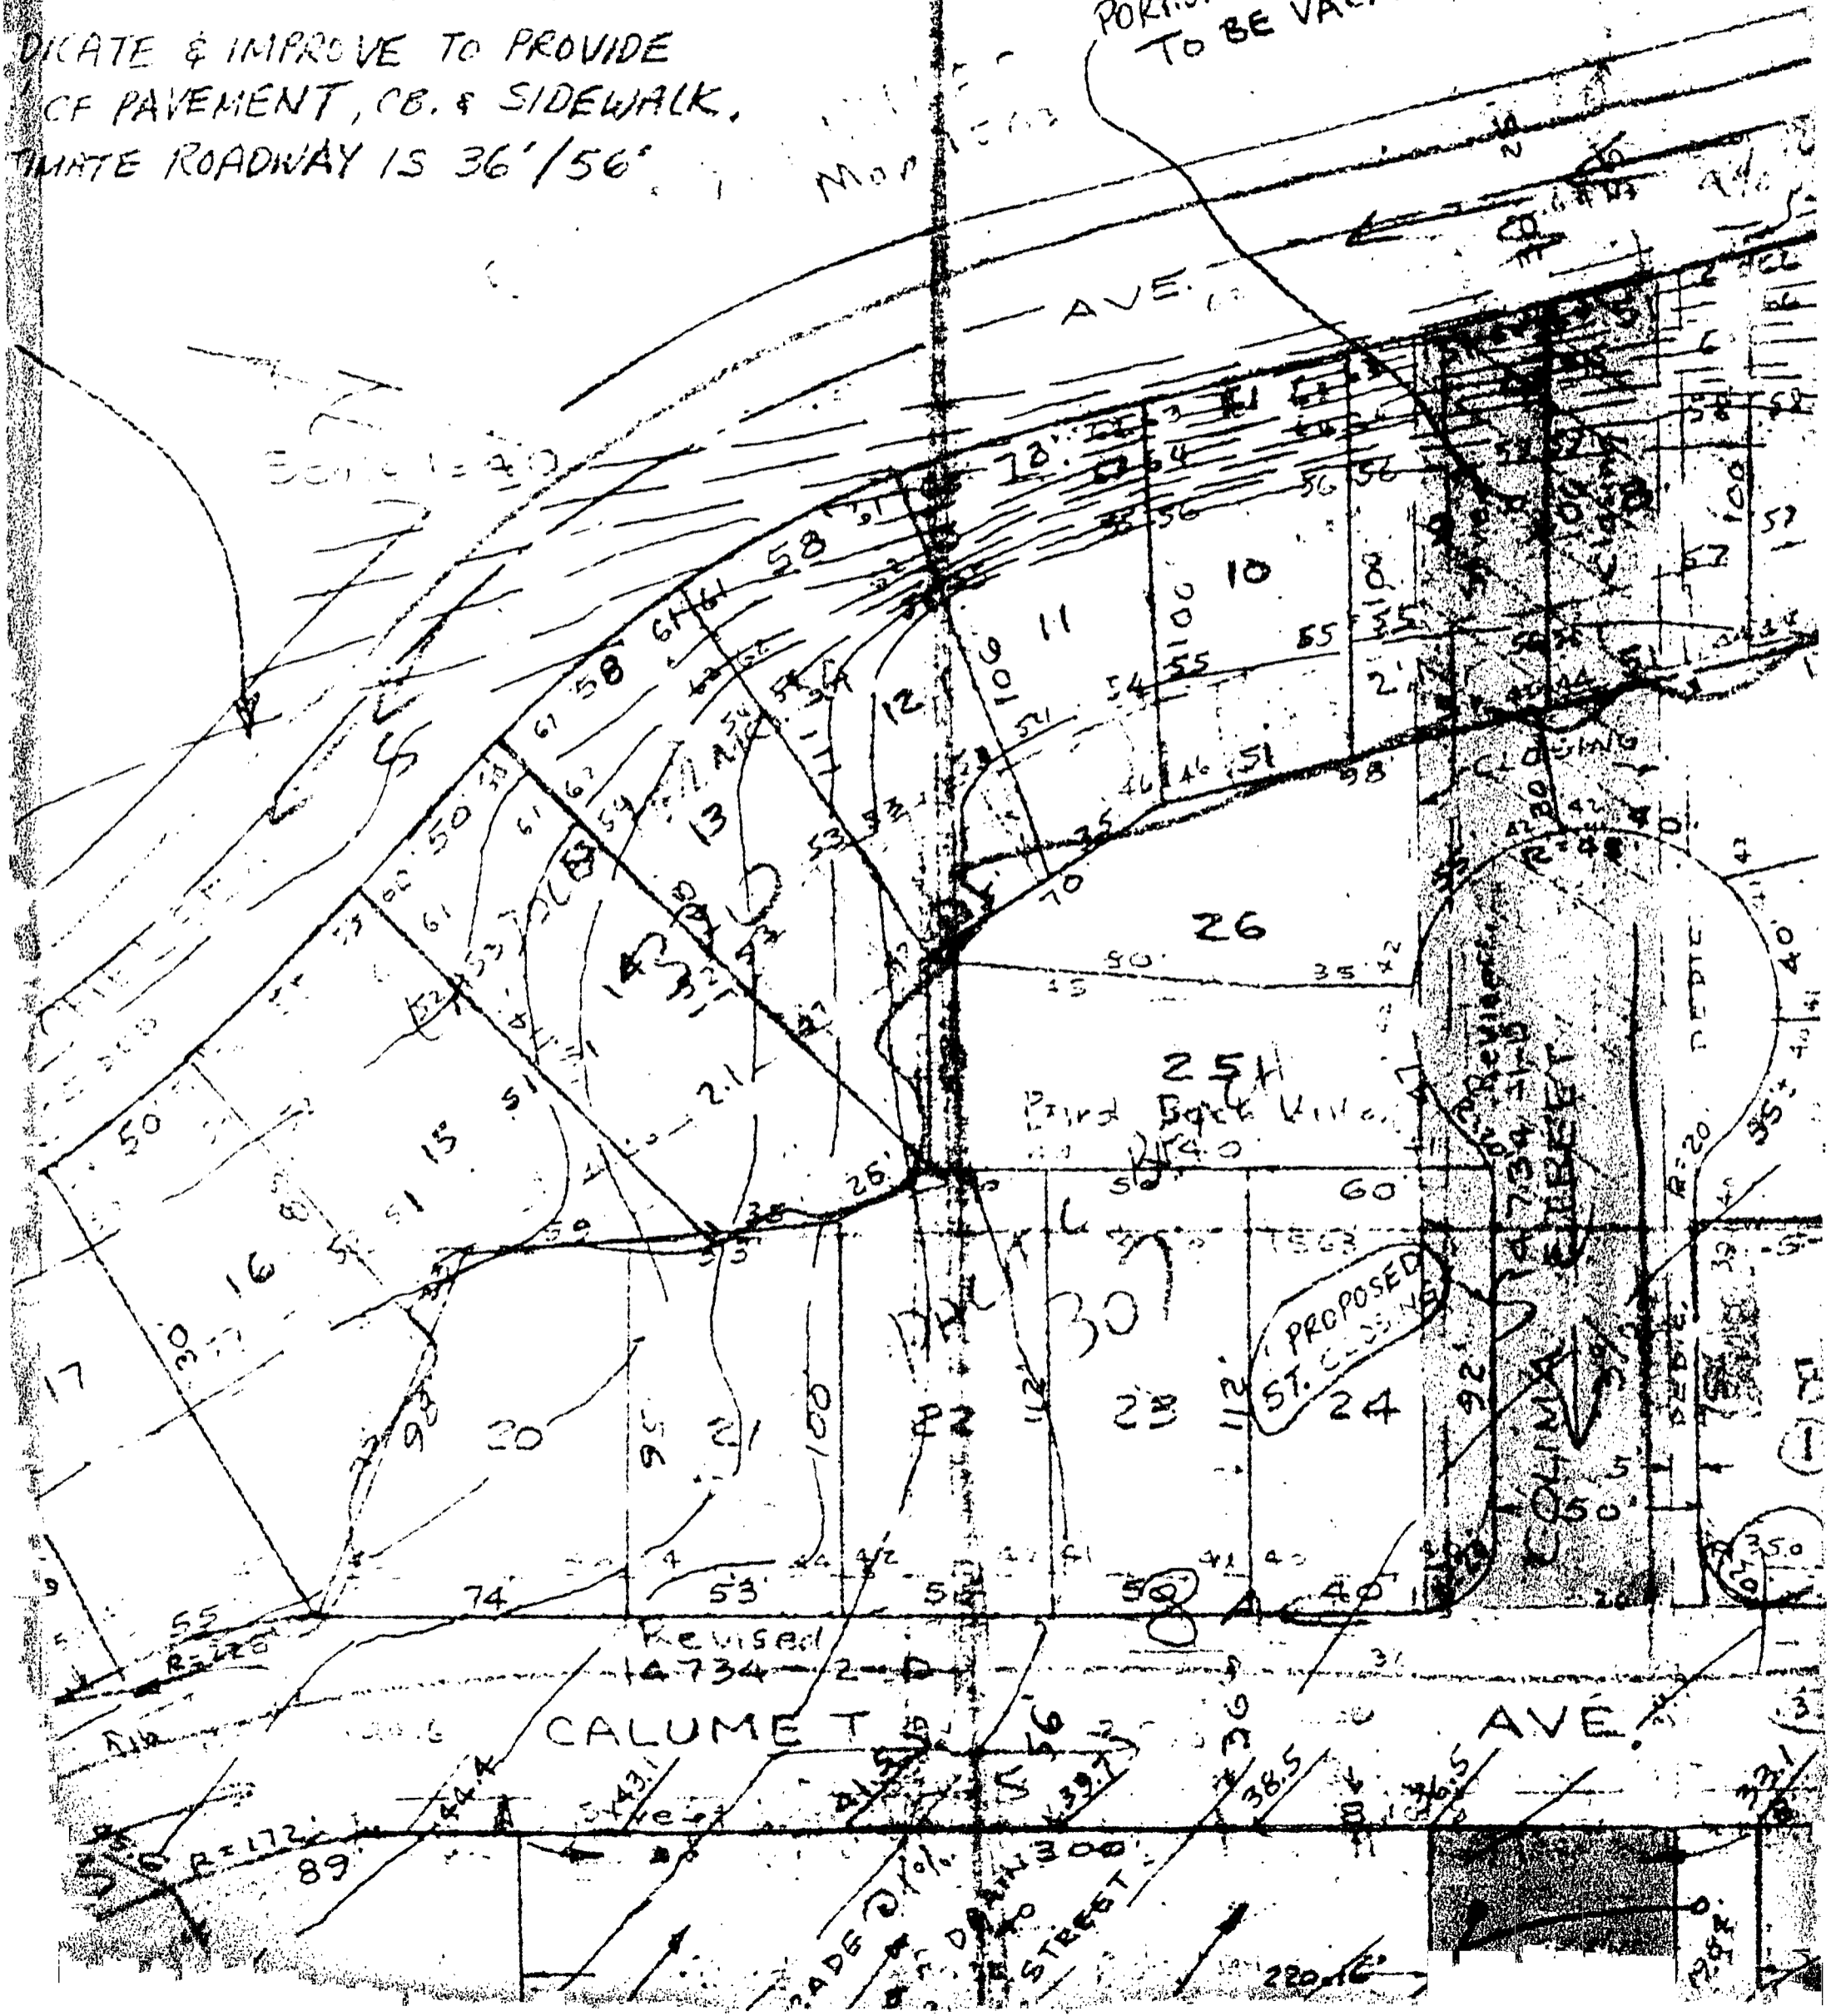

01325


01326

PORTION OF COLIMA ST.
TO BE VACATED

SIDE
WALK

AVE.

FULL WIDTH GRADING
REQ'D ON CHISEL

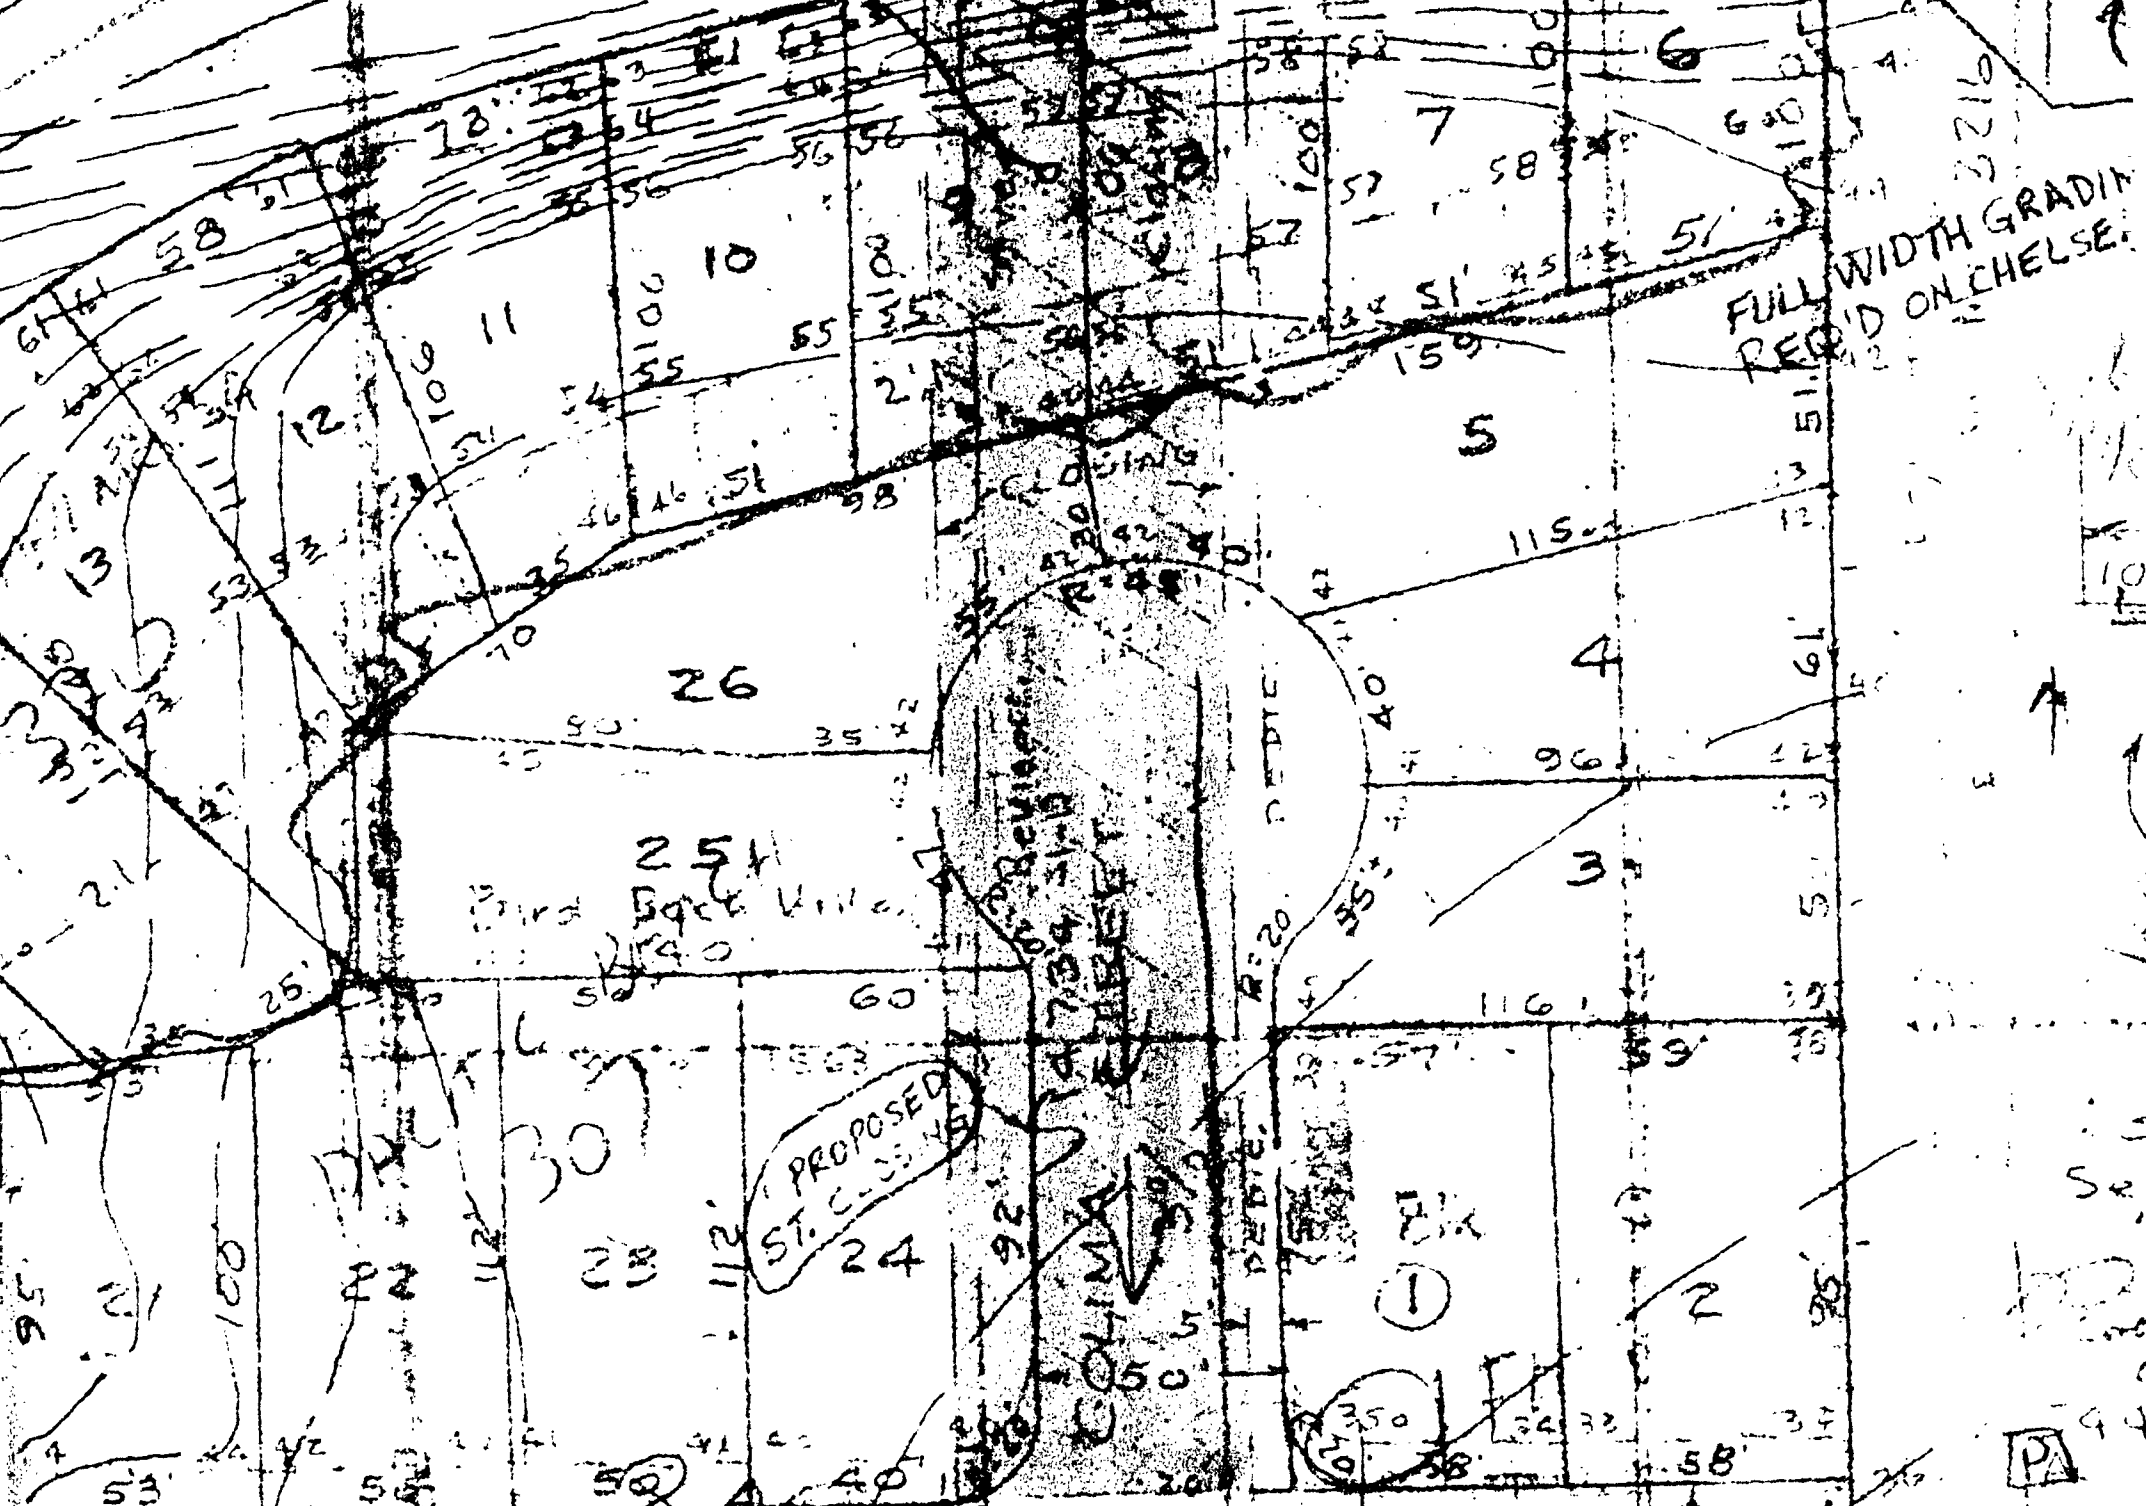

Revised
4734

UMET

AVE.

GRADED
DRAIN
STREET

See
PA
Bent
Dedicate


01326

01327


ST.
D

FH ①

EXIST SVC
R

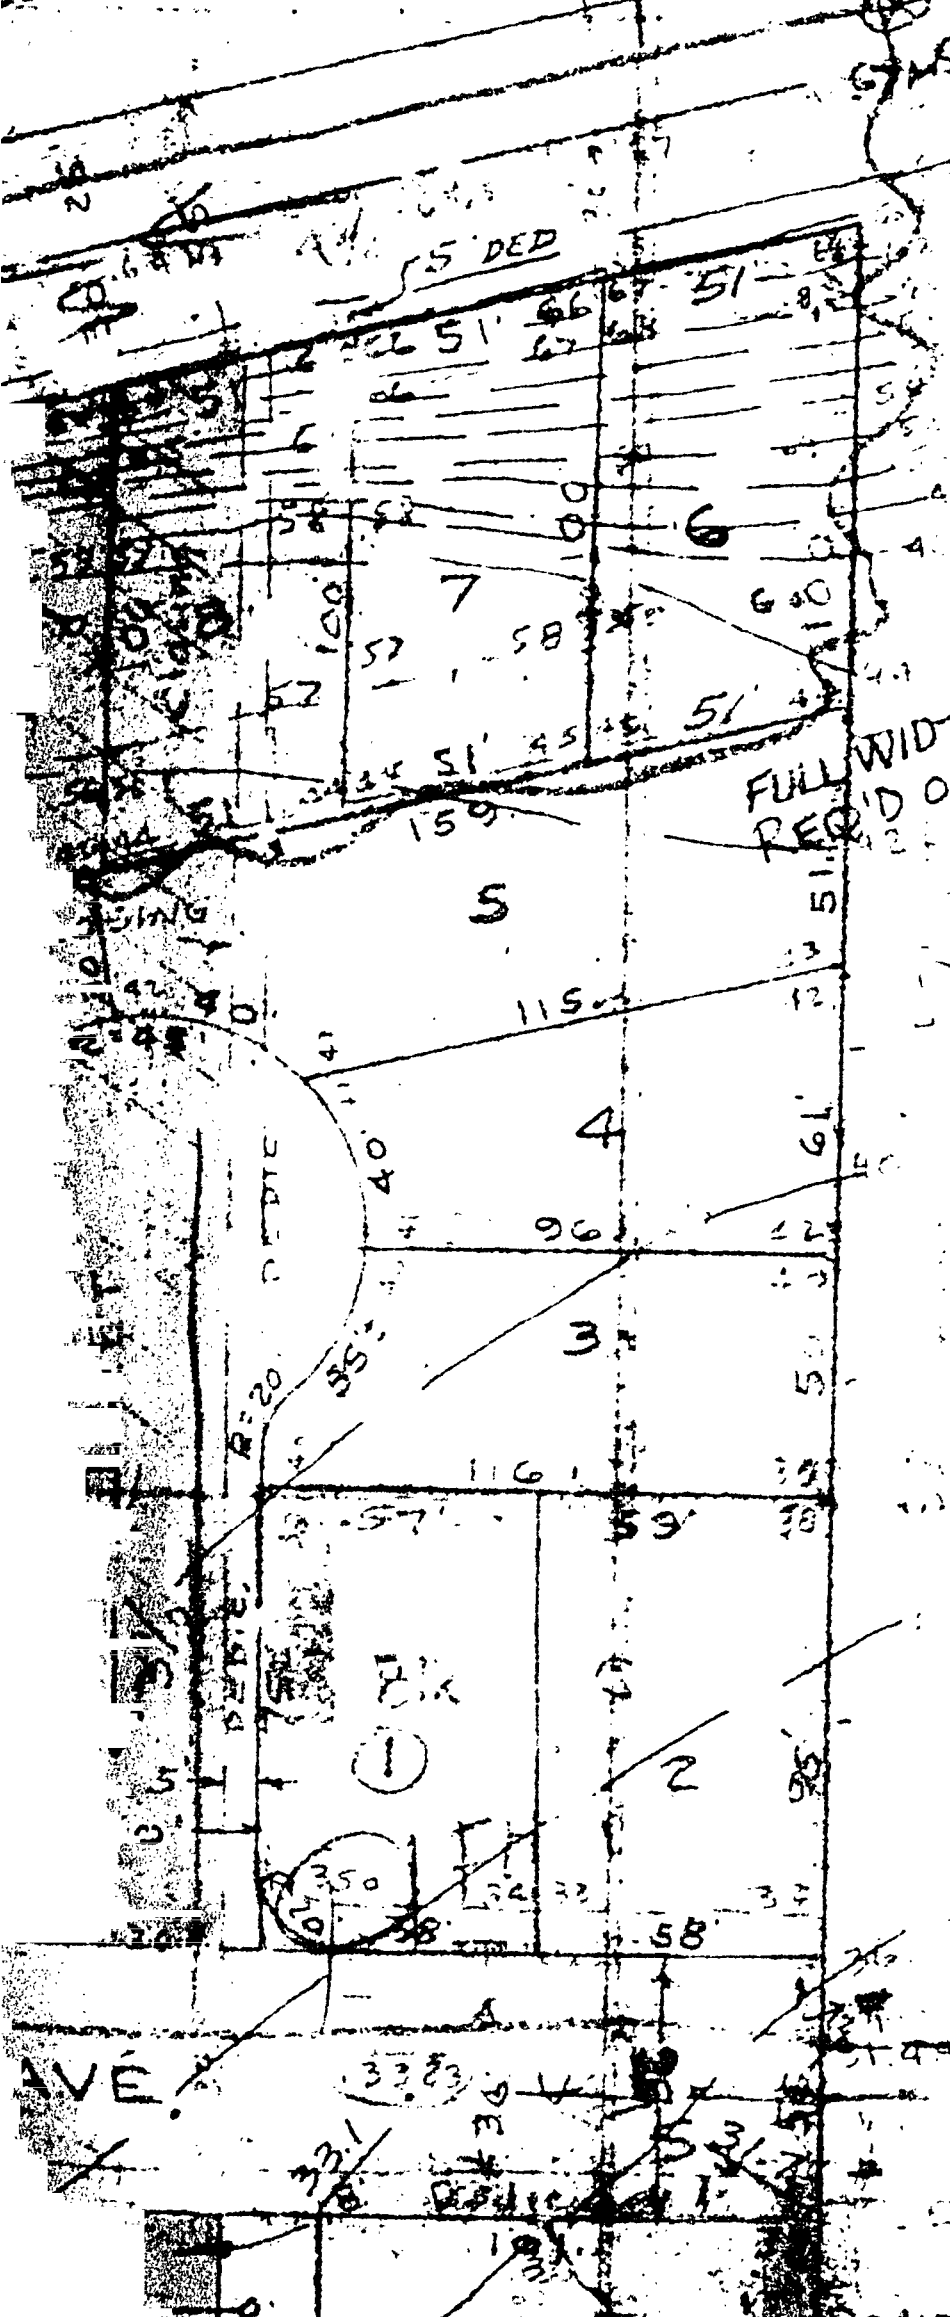


Type S Type H Pavement
Curb

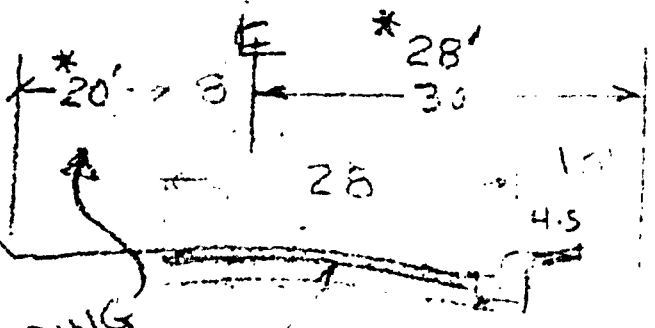

FULL WIDTH GRADING
REQ'D ON CHELSEA

Type S Curb
Pavement 4' PCC
Sidewalk

* CHELSEA AVE
MIDWAY ST.

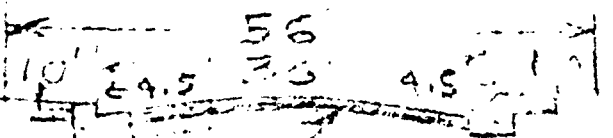

Type H
Pavement Type G
Curb
4' PCC
Sidewalk
STREET SECTION
CALUMET AVE.

See 12037 L San Gual

Robert L. [Name]
Owner

940 La Jolla Blvd
Phone 433-2727

EXIST SVC
FULL 25.52

See Storm Drain 18

Benton Engineering Inc.

Dedicate Soils Engineer 7-1-71

Essex San Diego Calif

Final
Swearing plan of
Improvement Plan

*** NOTE:**

~~LOT 30~~
~~AND THEREBY~~
DEDICATED ~~TO THE CITY~~
~~GRANT DEED TO THE~~
CITY SOLELY FOR PARK
AND RECREATION
PURPOSES, ~~AND~~
~~FOR THE~~
~~USE OF~~
~~THE~~
~~CITY~~

73-185
74-35


DUE 1.7.
4/28/75


73-185 REV.
DATE 4-28-75

LOT 30 SHALL BE SEEDED
FOR GROUND COVER, SATISFACTORY
TO THE CITY ENGINEER

MICROFILMED
MAY 18 1978

01328

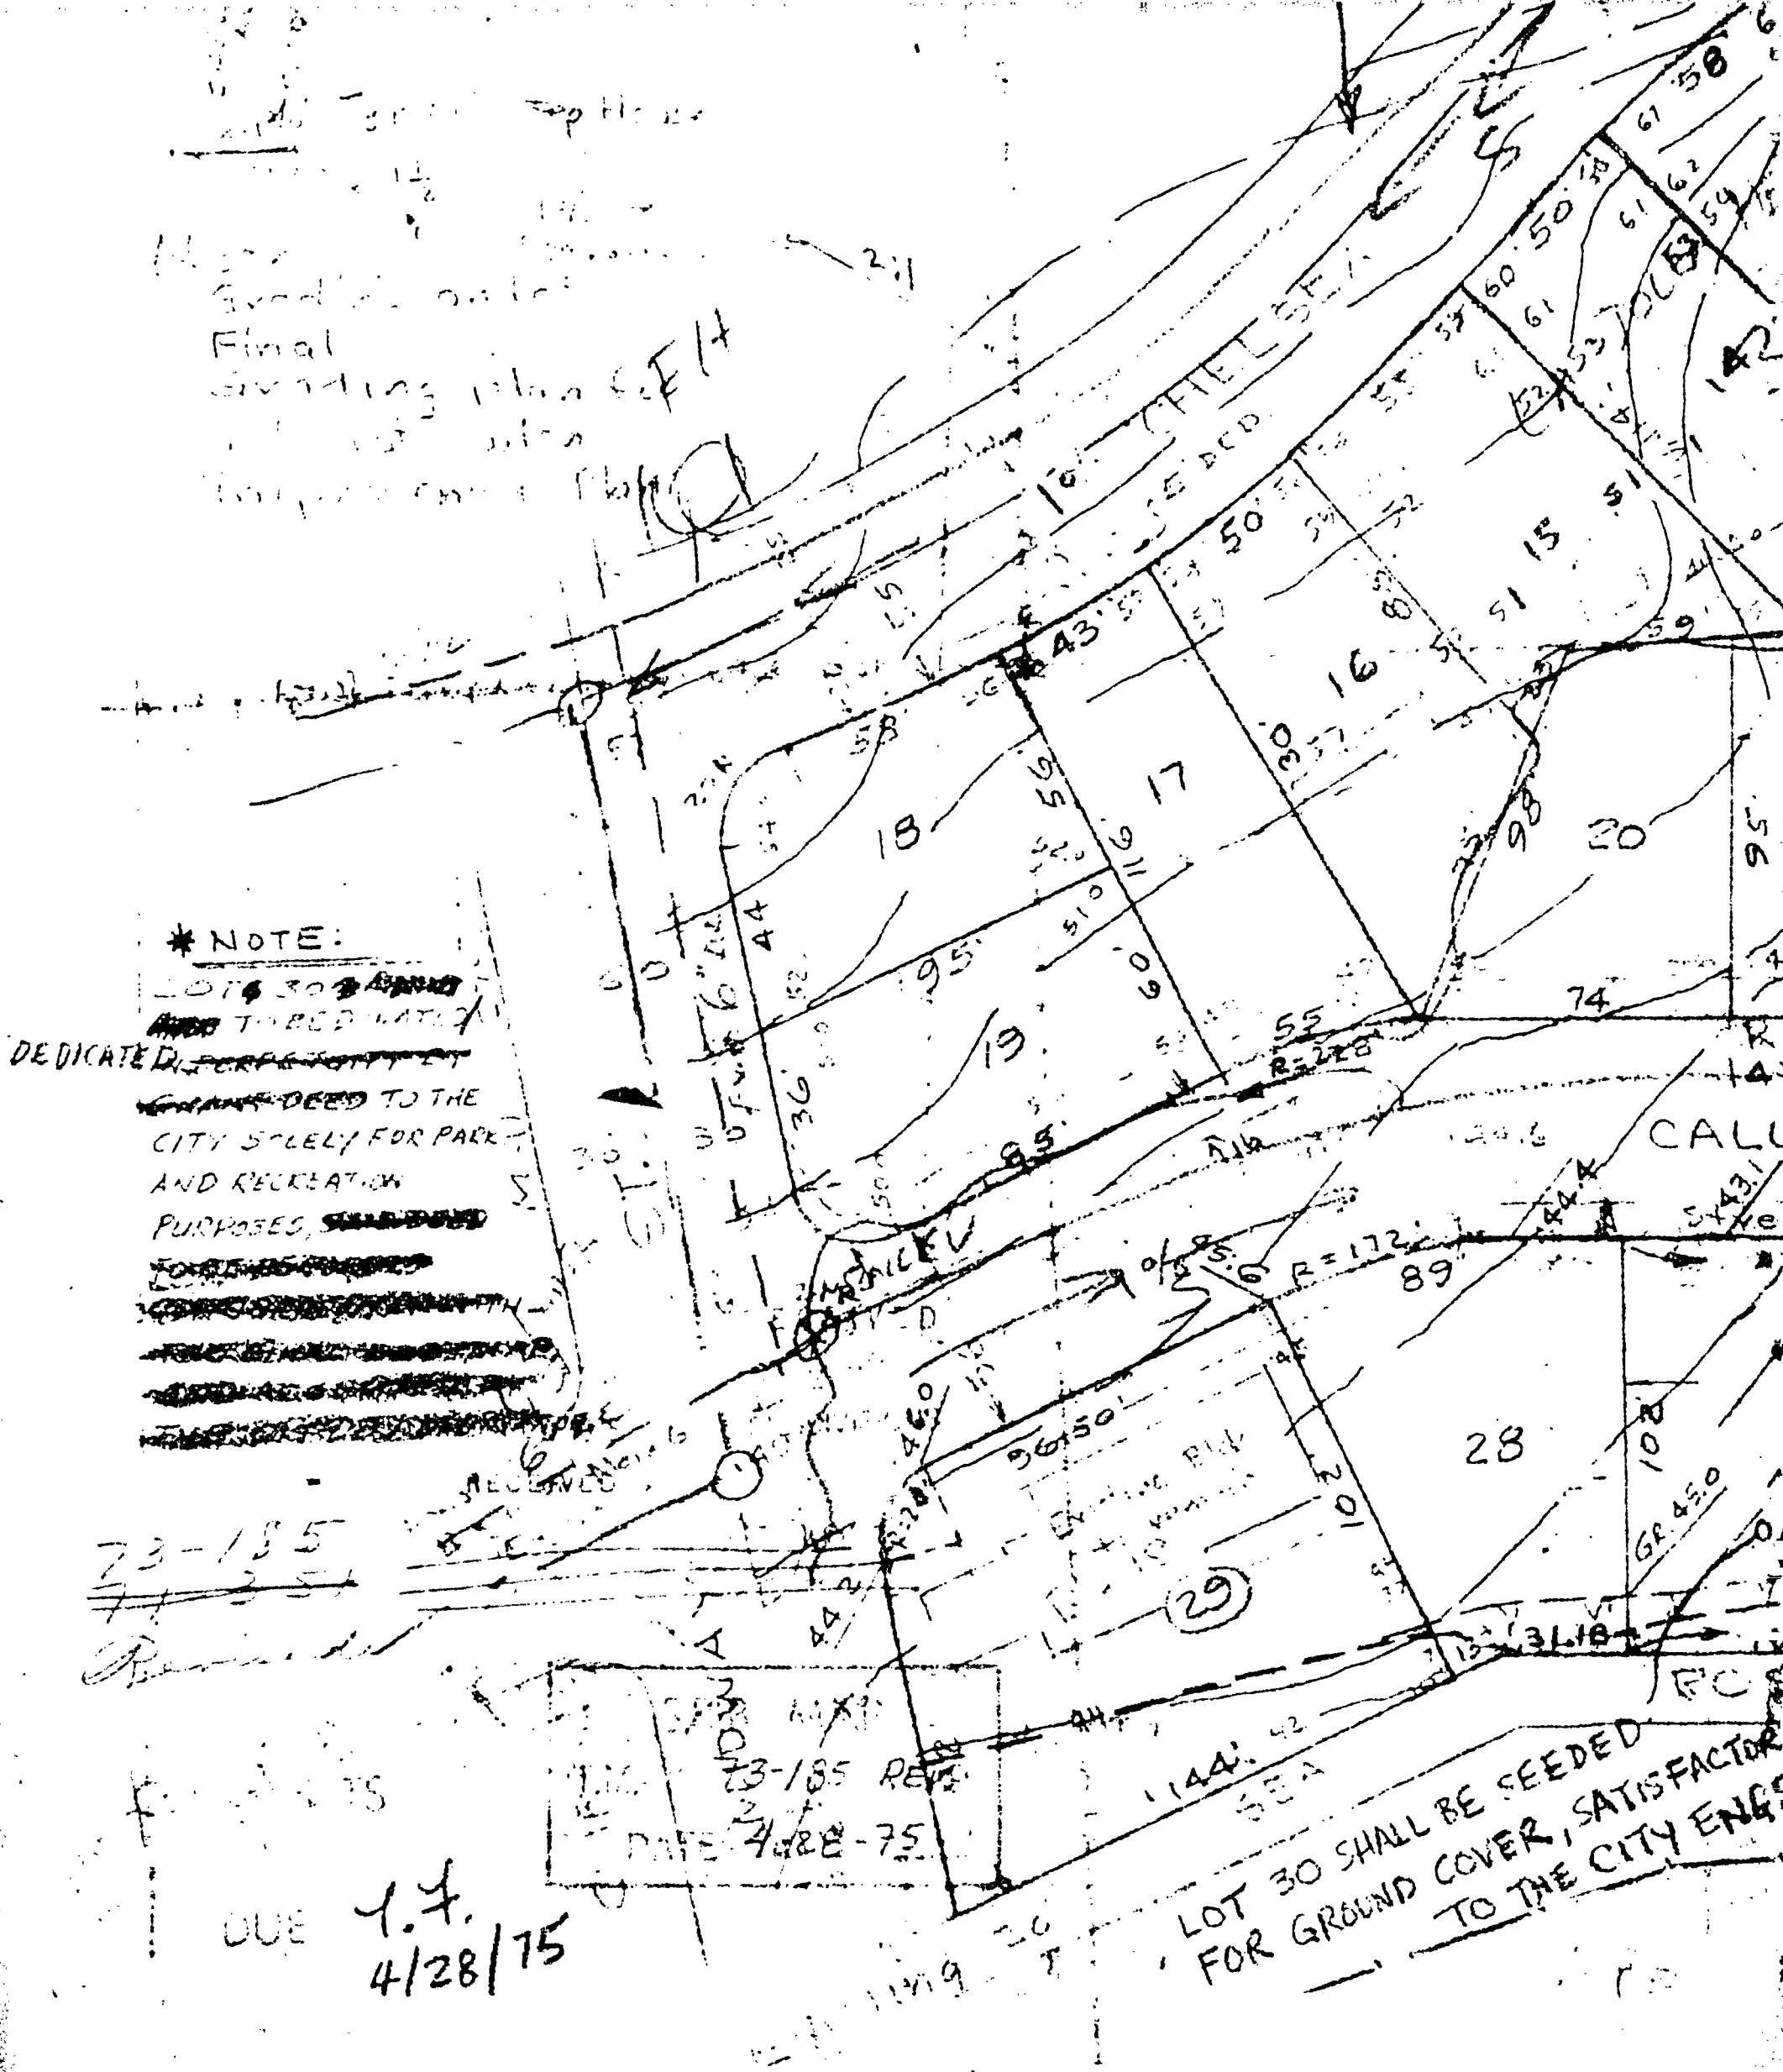

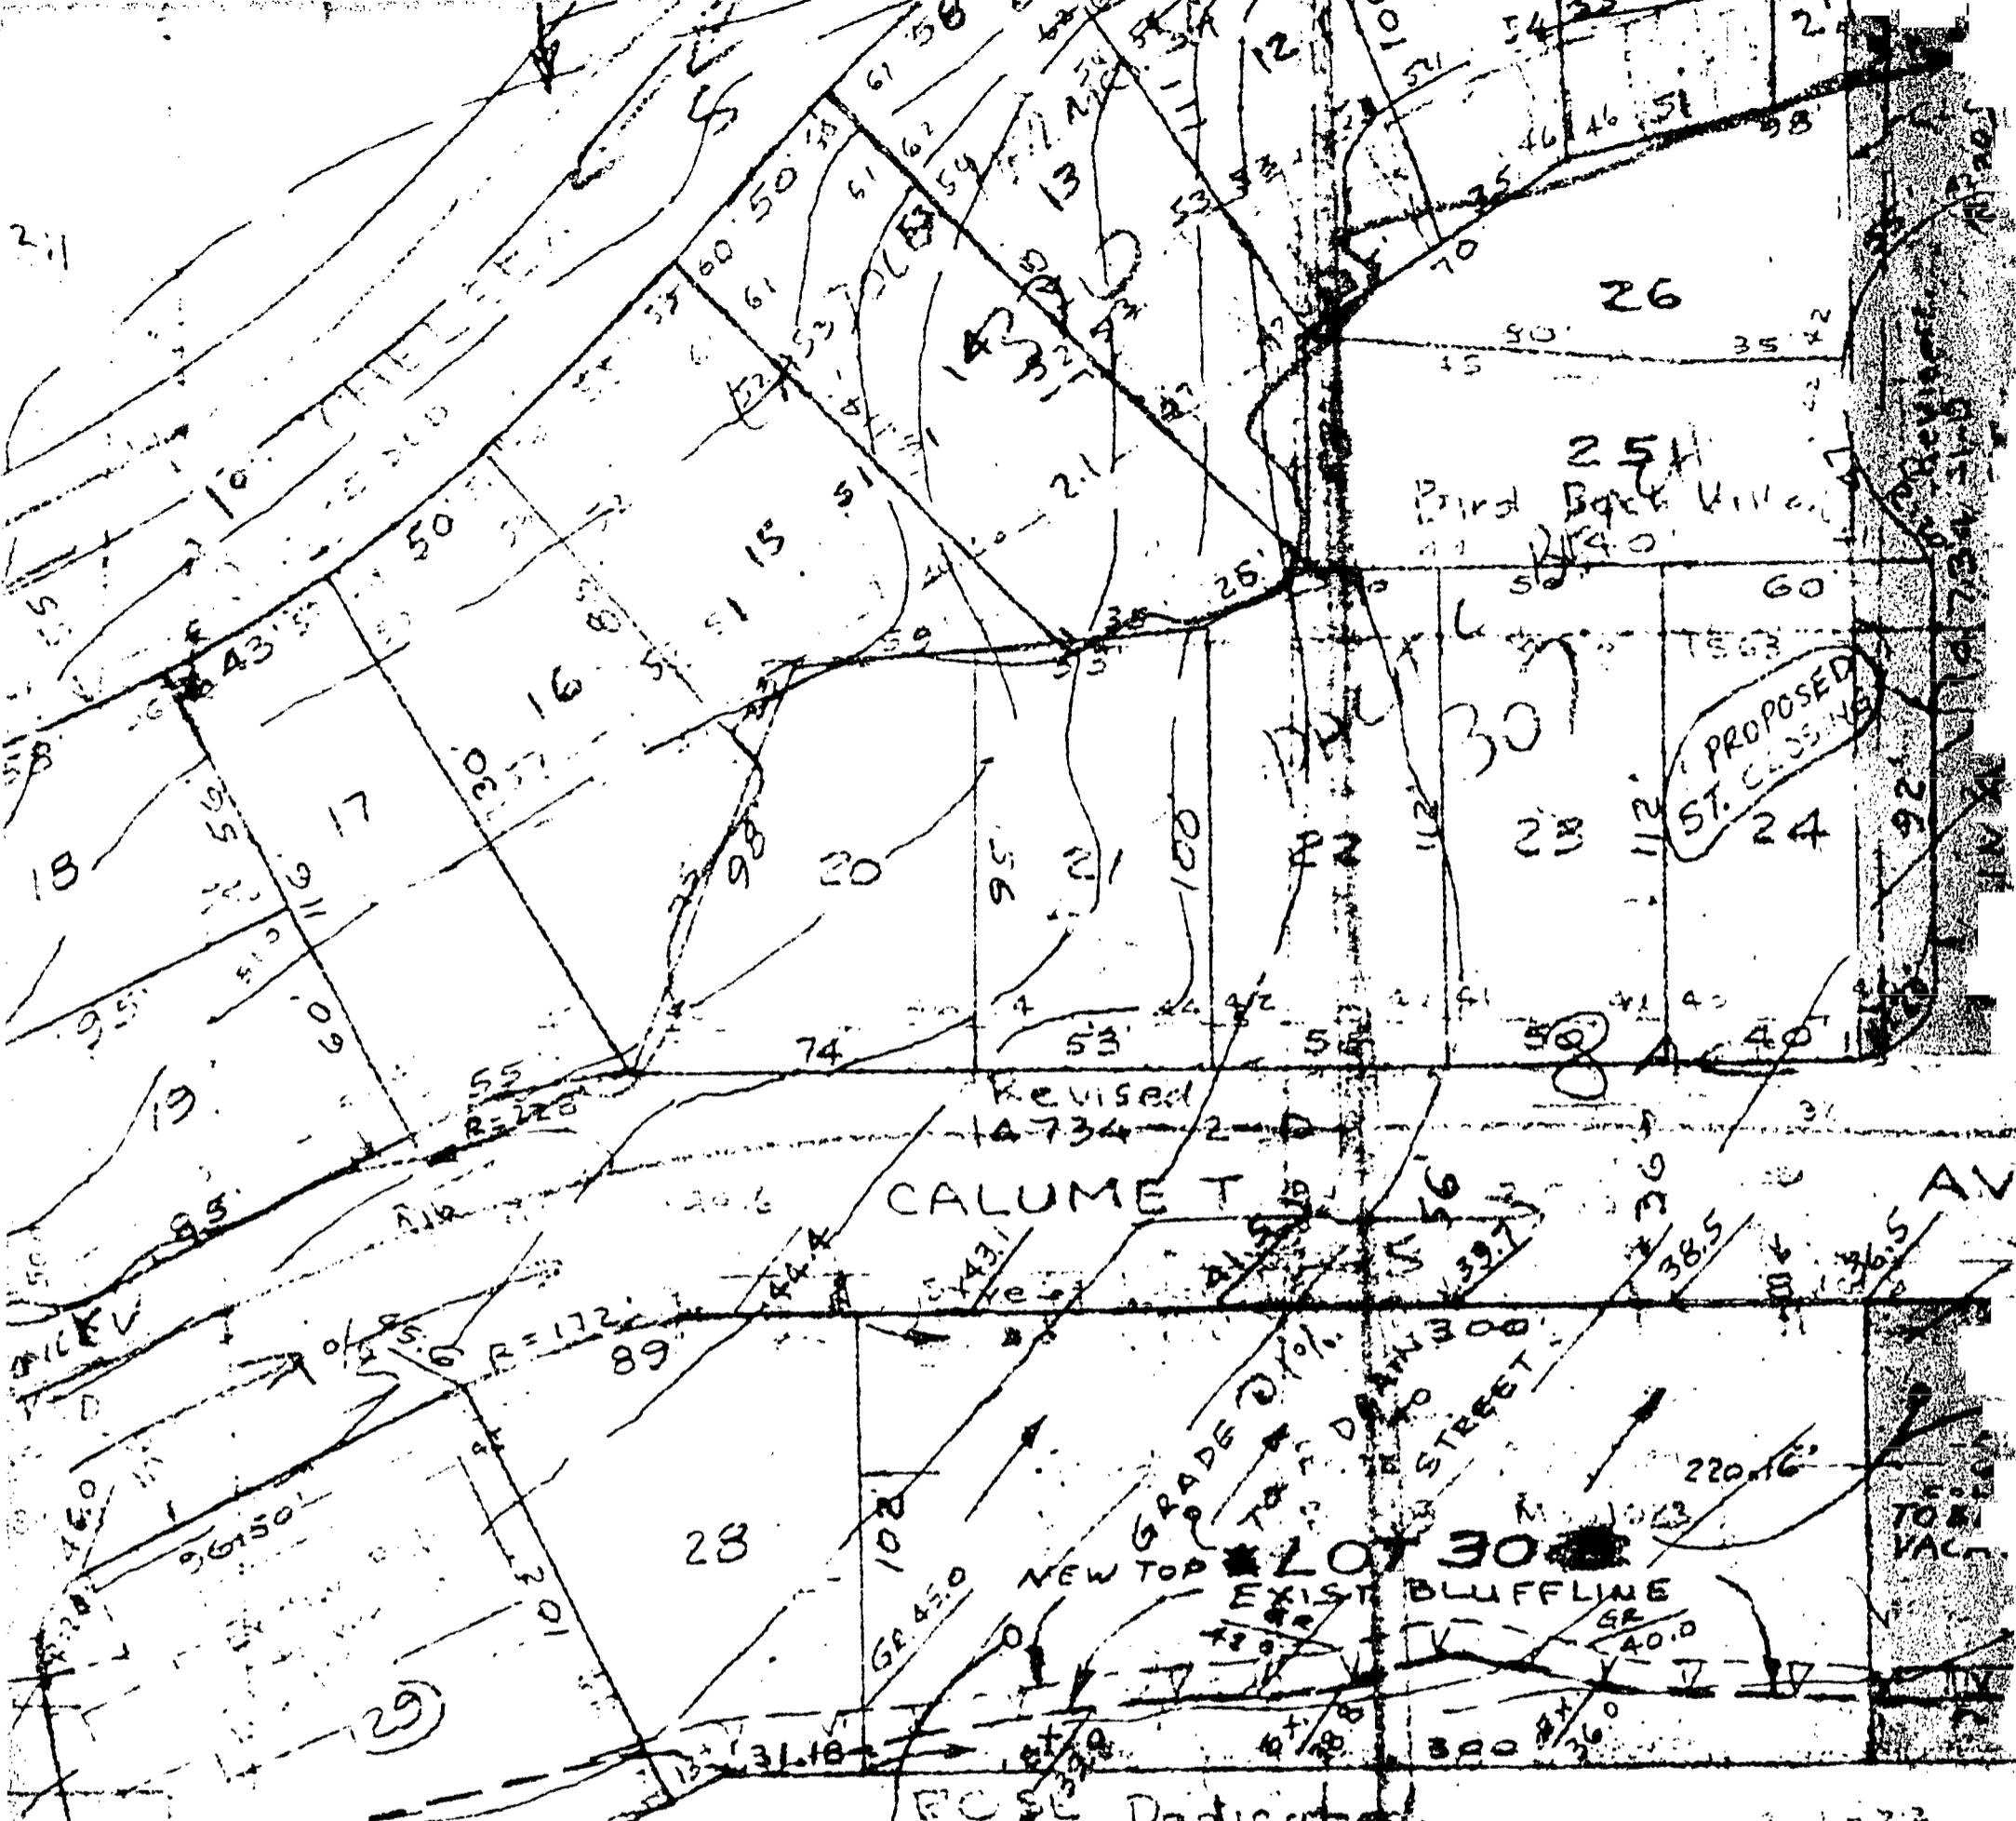


LOT 30 SHALL BE SEEDED
 FOR GROUND COVER, SATISFACTORY
 TO THE CITY ENGR.

High Tide Line 4719 L
 Pacific Ocean
 PLEASANT


FILMED
 18 1978

01329

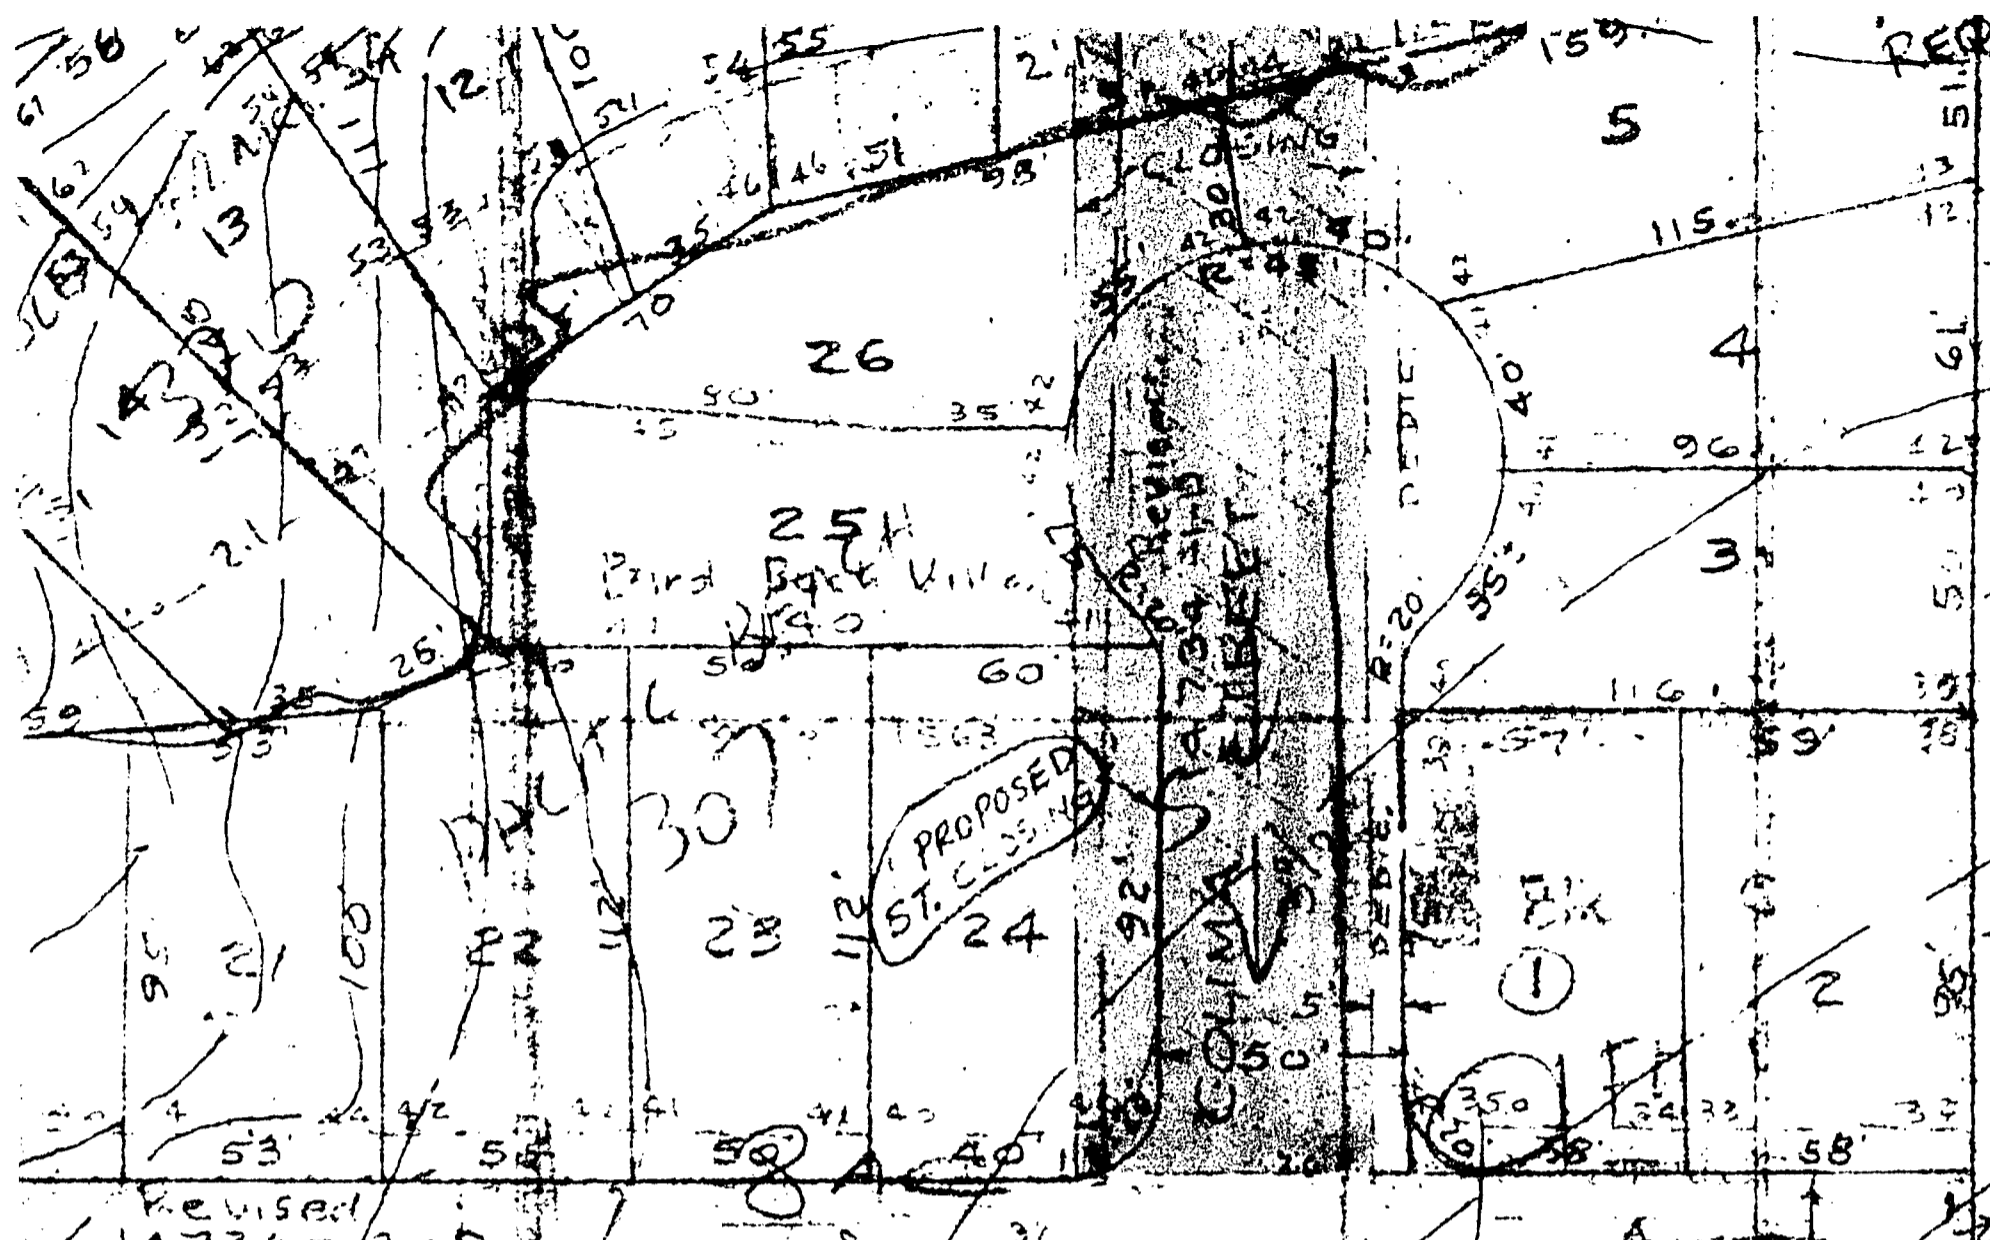


REVISION 14734

CALUMET AVE

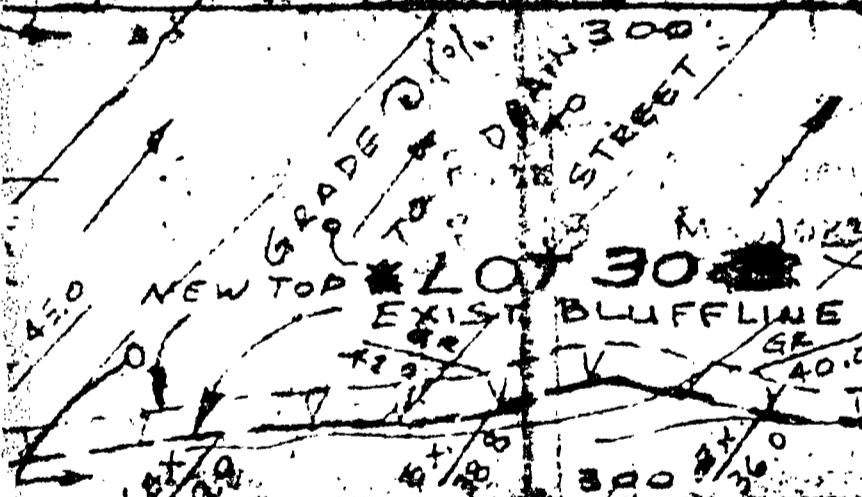

FACTORY ENGR.



Dedicated
High Tide Line 4719 L

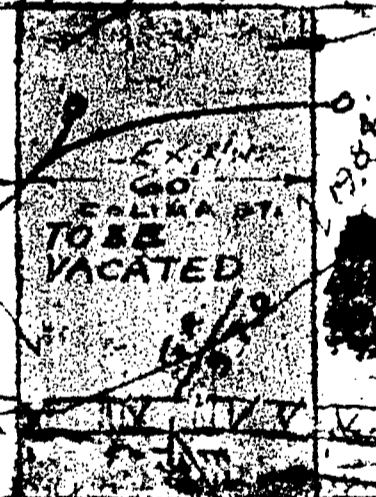

PLANE
22' to Rocks

Ocean (A-B)
PL-EG-NE 73-04-1001P
REQUIRE

Dedicate
MUNK
SHEET
CAL
DRAWN: F. H.
CHECKED
T.C.L.

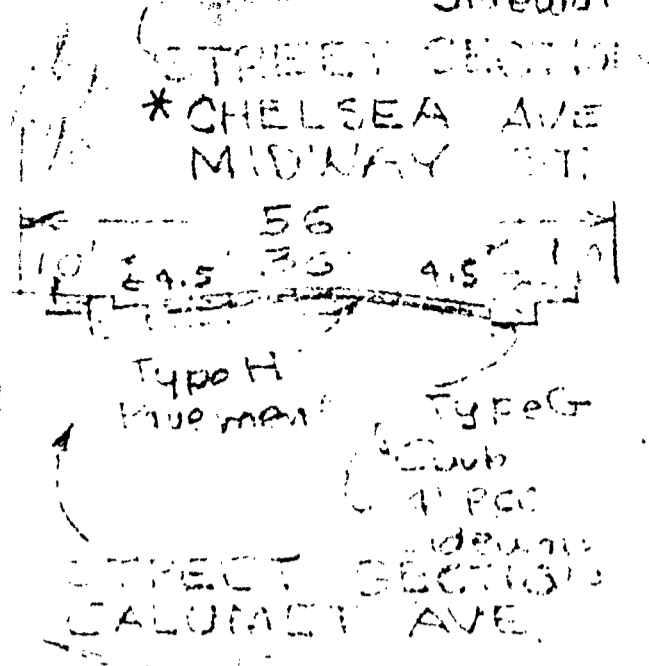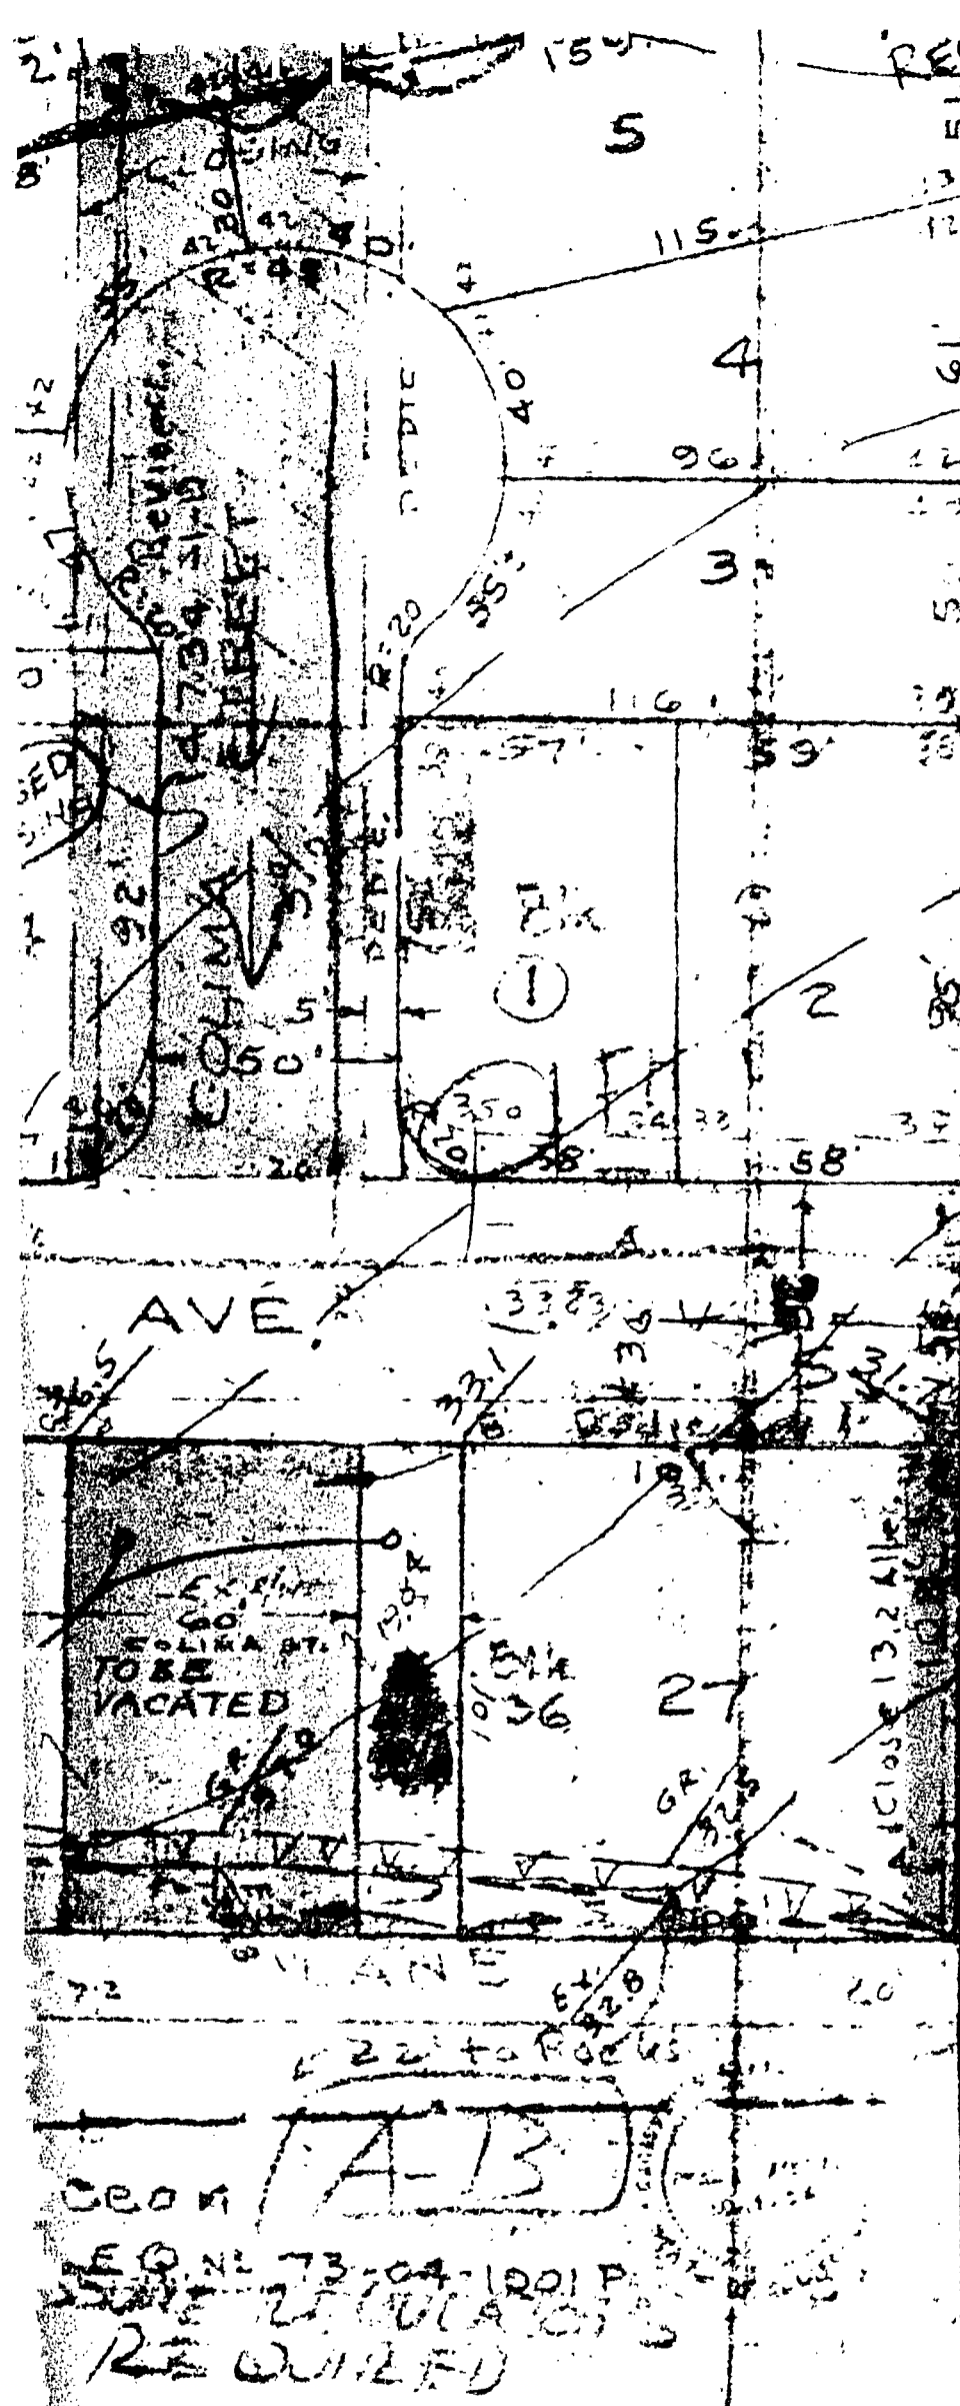

See 12037 L San Gual

Robert L. [Signature]
Owner

940 La Jolla Blvd
Phon 433-2727
FL CL 2532

Benton Engineering Inc
Dedicate Soils Engineer 7-1-71
Edema San Diego Cal

MUNICIPAL ENGINEERS INC. CIVIL ENGINEERS & LAND SURVEYORS 615 A ST. E. SAN DIEGO, CAL. 92101 TE 235-8171		
SHEET REVISED OF	SHEETS	
29 LOTS + 2 PARK LOTS CALUMET PARK		
DATE: 3-27-73	REVISIONS	SCALE: 1" = 40'
CHECKED	12-11-73	JOB NO: 5953
	1-7-74	DWG. NO:
	3-6-74	
	3-27-74	
	3-10-75	

CEON A-B
EQ. NO. 73-04-1201 P
RE QUIRED

01330

DOCUMENT NO. **752191**
FILED **AUG 4 1975**
OFFICE OF THE CITY CLERK
SAN DIEGO, CALIFORNIA

01331

AUG 28 1975

Passed and adopted by the Council of The City of San Diego on _____,
by the following vote:

Councilmen	Yeas	Nays	Excused	Absent
Gil Johnson	<input checked="" type="checkbox"/>	<input type="checkbox"/>	<input type="checkbox"/>	<input type="checkbox"/>
Maureen F. O'Connor	<input type="checkbox"/>	<input checked="" type="checkbox"/>	<input type="checkbox"/>	<input type="checkbox"/>
Lee Hubbard	<input checked="" type="checkbox"/>	<input type="checkbox"/>	<input type="checkbox"/>	<input type="checkbox"/>
Leon L. Williams	<input type="checkbox"/>	<input type="checkbox"/>	<input type="checkbox"/>	<input checked="" type="checkbox"/>
Floyd L. Morrow	<input type="checkbox"/>	<input checked="" type="checkbox"/>	<input type="checkbox"/>	<input type="checkbox"/>
Bob Martinet	<input checked="" type="checkbox"/>	<input type="checkbox"/>	<input type="checkbox"/>	<input type="checkbox"/>
Jim Ellis	<input checked="" type="checkbox"/>	<input type="checkbox"/>	<input type="checkbox"/>	<input type="checkbox"/>
Jess D. Haro	<input type="checkbox"/>	<input checked="" type="checkbox"/>	<input type="checkbox"/>	<input type="checkbox"/>
Mayor Pete Wilson	<input checked="" type="checkbox"/>	<input type="checkbox"/>	<input type="checkbox"/>	<input type="checkbox"/>

AUTHENTICATED BY:

PETE WILSON

Mayor of The City of San Diego, California.

(Seal)

EDWARD NIELSEN

City Clerk of The City of San Diego, California.

By Kathleen Martiniz, Deputy.

RECEIVED
CITY CLERK'S OFFICE
1975 JUL 22 AM 8 18
SAN DIEGO, CALIF.

Office of the City Clerk, San Diego, California

Resolution Number **214123** Adopted **AUG 28 1975**

CC-1276 (REV. 1-75)

MICROFILMED
01332 MAY 18 1978